



FRONT ELEVATION - LEMNAN STREET

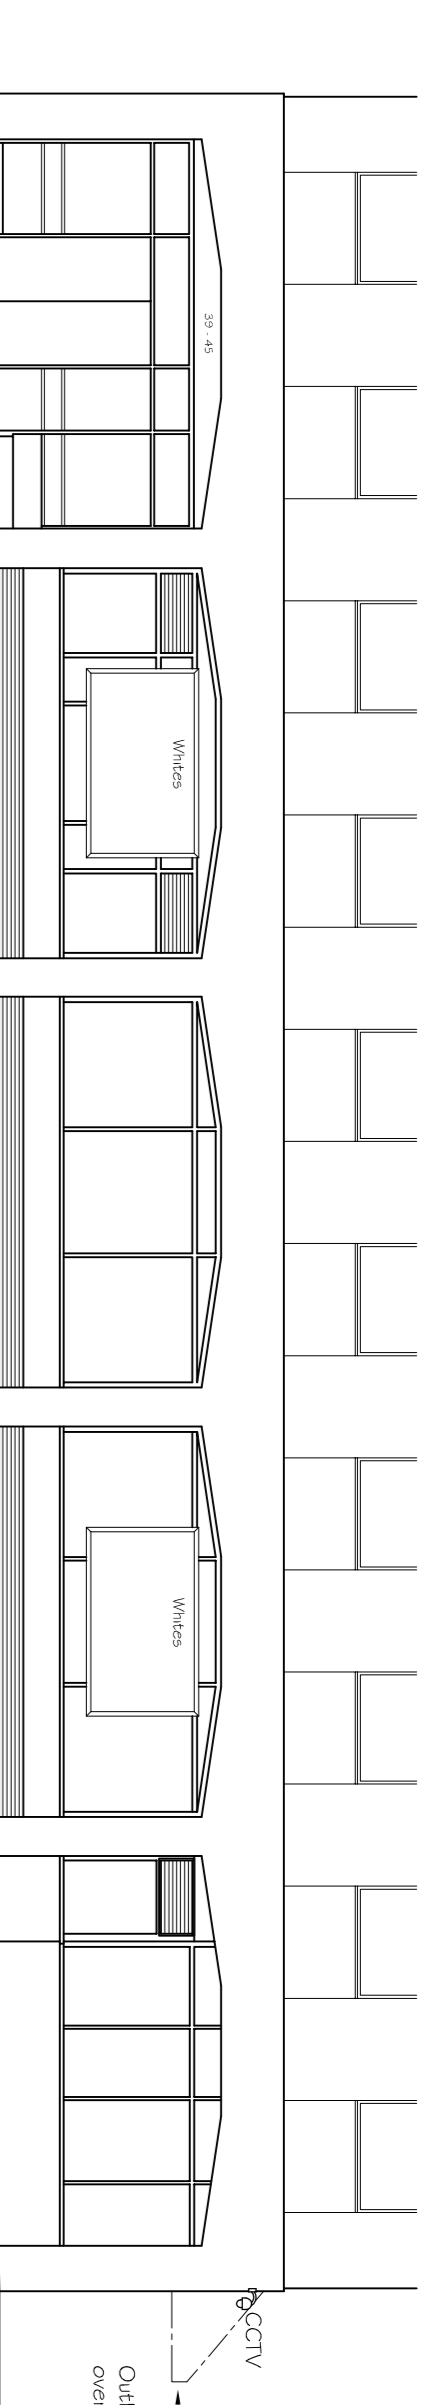


FLANK ELEVATION - AILE STREET

**PRELIMINARY DRAWING -
SUBJECT TO APPROVAL**

Red line on Plan indicates location and extent of that part of the premises which will be licenced.

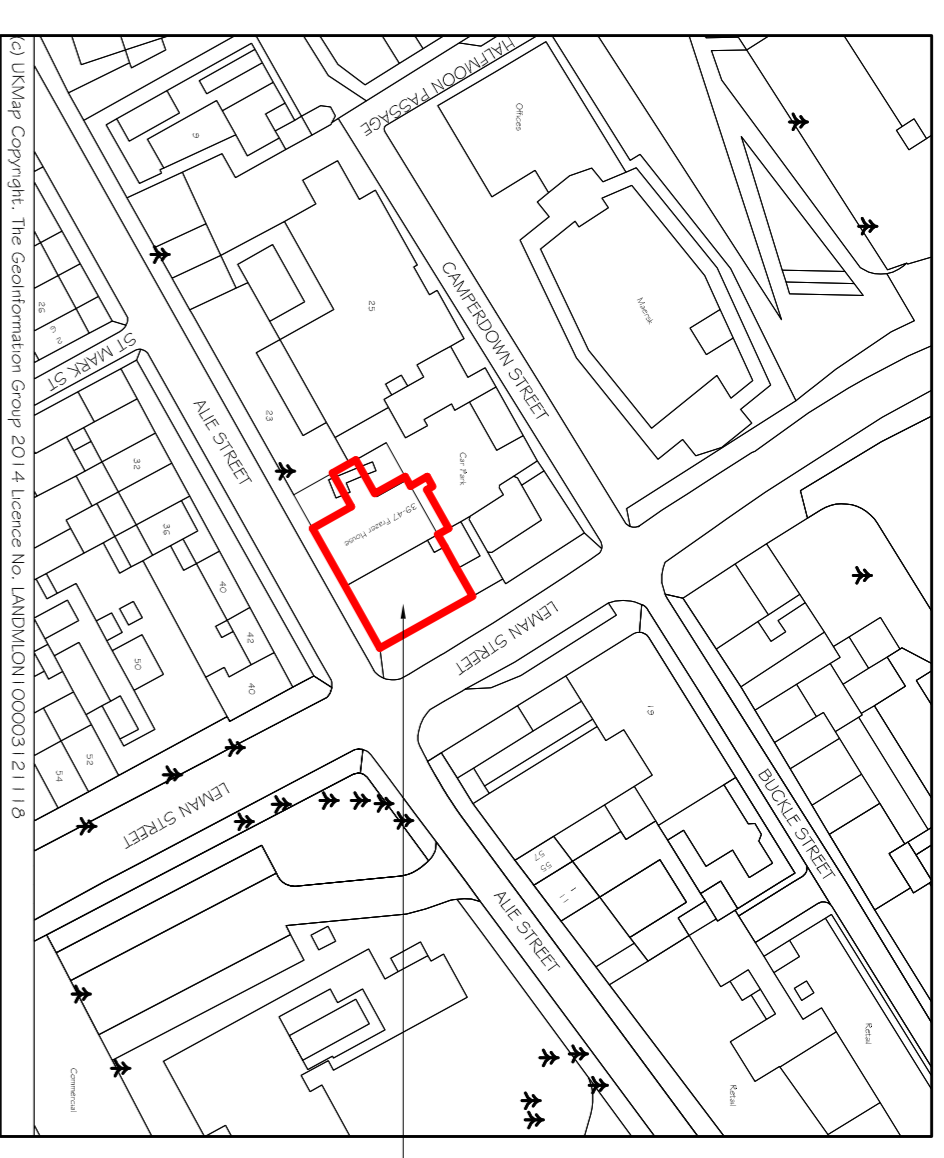



SITE LOCATION PLAN 1 : 250

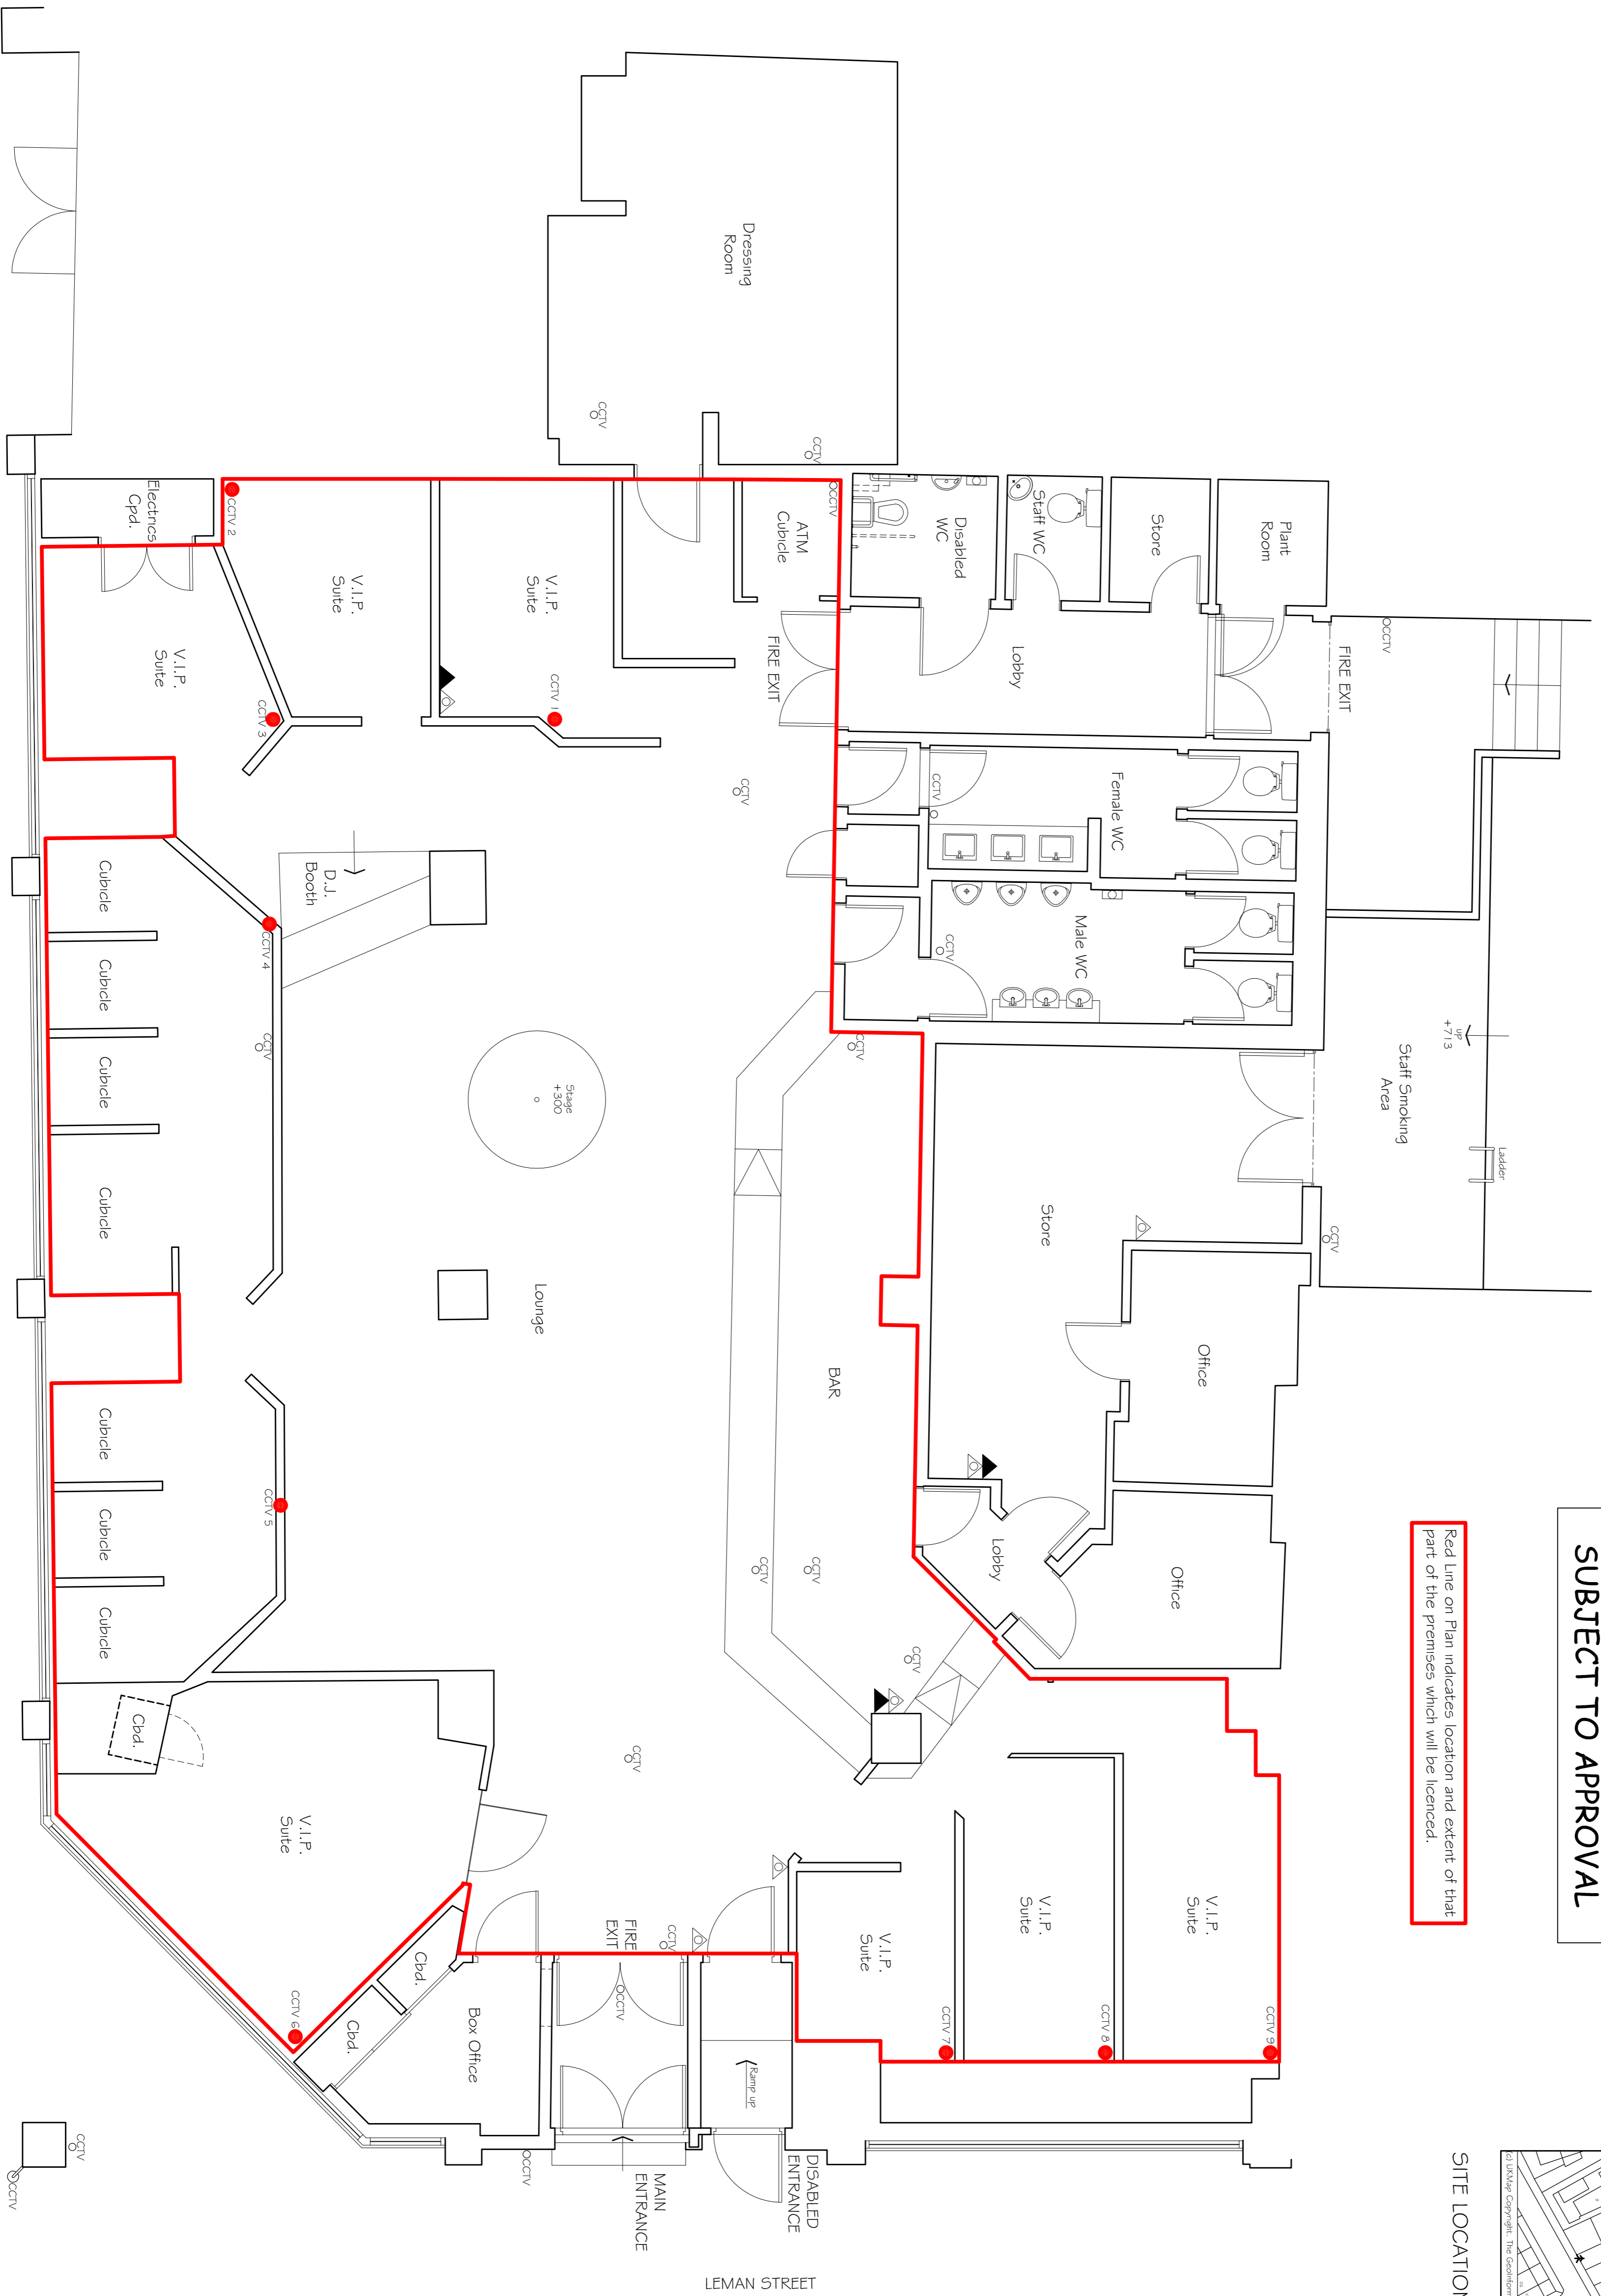

GROUND FLOOR PLAN

AILE STREET

LEMNAN STREET

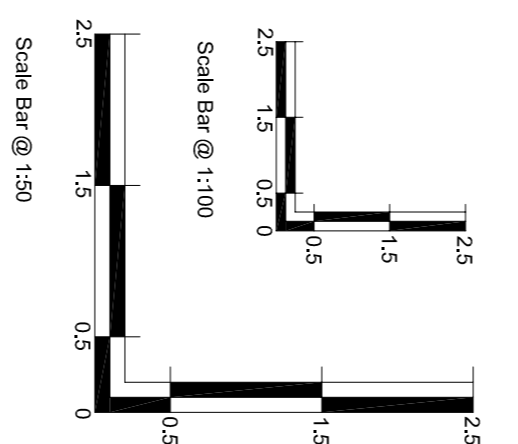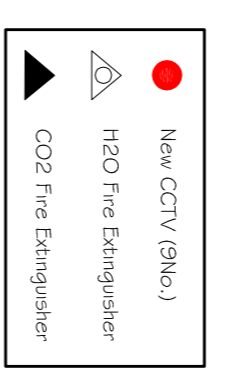

| Revision | Date | Rev |
|--|------------|-----|
| Actual position of CCTV's & Fire Extinguishers shown | 27.10.2014 | A |
| 9th. new CCTV's added | 26.03.2015 | B |
| New CCTV's 1 - 9 repositioned | 26.03.2015 | C |

Client

Whites
32-38 Lemnan Street,
London,
E1 8EW

Title

Licence Sketch SK01

Scale 1:50, 100 @ A1 Date Oct 2014

Drawn By NMP

Checked By . Rev. C

Dwg. No. 14/3989/SK01

Eaton Strevens Associates
129 Grosvenor Street
Consilient House
E8 9LW
Tel: 01992 639782/637510
Fax: 01992 640364
Email: eatonstrevens@btclick.com

RICS
CHARTERED SURVEYORS

© This drawing is the copyright of Eaton Strevens Associates.